

INSTRUCTIONS

1. Description of evidence found, note discrepancies in the record, state method of establishing lost corners.
2. Description of monument and accessories set to perpetuate the corner position.
3. Sketch of corner, show all pertinent data which can best be shown in a sketch example, corner marking, topography lines, position of accessories, etc.
4. Certification must be signed and sealed by Land Surveyor registered in the State of Montana.
5. Fill in Cross Index & Section Diagram at bottom of sheet.

CERTIFIED CORNER RECORDATION

Corner SEC. COR 30 | 29 31 | 32 T. 6N R. 9W P.M.M. Deer Lodge County

1869 GLO Record: 'Drove a charred stake, raise mound of earth with pits....'

March, 1977 Corner Form (1888ES): 'Found a set stone 4"x12"x11" out of ground, 5 marks on East face, 1 mark on South face



November, 1992, Found: We find no evidence of original corner, nor of stone noted on 1977 corner form. Shortly after the 1977 corner form was prepared, Interstate Highway 90, was constructed and the corner was destroyed. We compute a position for the corner based on ties shown on the Interstate 90 plans. The corner form on file for the NE corner of Section 32 (1888ES) shows a tie to the NW corner of Section 32 as N.89°03'02"W., 5252.97 feet. We find N.89°15'58"W., 5253.43 feet, confirming the location as computed from I-90 plans.

December, 1993, Set: At above noted computed position, set a 5/8" X 24" rebar with 3-1/4" PCI alum. cap, 1" above ground, marked as shown below.

Corner lies 12ft. east of east edge asphalt of southbound on-ramp of the interstate highway (Galen exit), and 33ft. south of south edge asphalt of E-W county road.

From the corner we note the following nearby references:

- * The center of an I-beam post, the south post of a 'Butte - Missoula' direction sign, brs. N.15°E., 14.2 feet.
- * Nailed a 1" YPC top (PCI 406-728-1880) to the north face of a fence corner post. Fence runs east under interstate & southwesterly to cattle-guard. brs. N.85°E., 63.7 feet

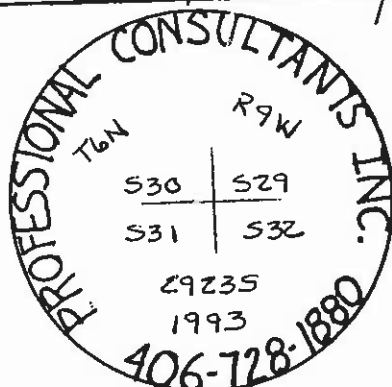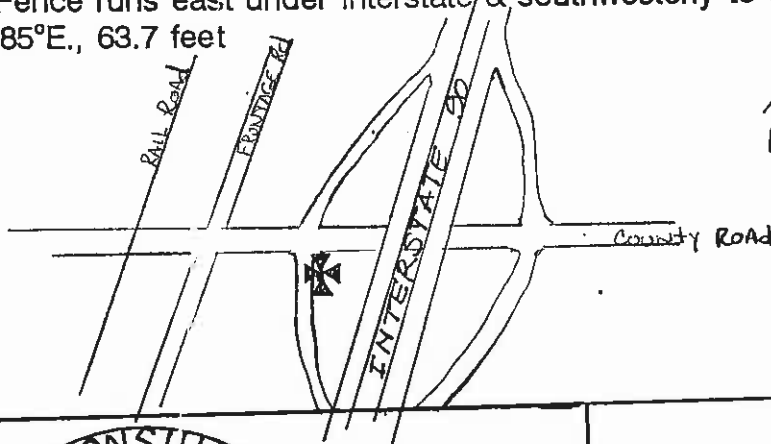

SKETCH OF CORNER

CERTIFICATION

I, Duane G. Schmitz
 certify the information shown herein is true and correct.
Duane G. Schmitz
 Signature Ground Party Chief

I, Richard A. Ainsworth
 certify that this corner record correctly represents work performed by me or under my direction in compliance with the "Corner Recordation Act" (70-27-101, et seq., M.C.A.)
RICHARD A. AINSWORTH
 State of Montana Surveyor & Seal
 Date: 12/93 Reg. No. 292329235
 Employer: Professional Consultants, Inc.

Office of Clerk and Recorder, County of Deer Lodge. This "corner record" was filed for record on December 16, 1994 was noted on the cross-index plat and is assigned page No. 381, in book No. 2 Mellie Anderson - Deputy County Official

Sec. 32

• - corner this sheet